

**NOTE:**

1. DRAWING REPRESENTS BUILDING(S) IN EXISTING STATE AS COMPOSED FROM ONSITE MEASUREMENTS AND DETAILED OBSERVATIONS (PHOTOS).
2. STATED DIMENSIONS, ARE DERIVED FROM THE USE OF A MEASURING TAPE DEVICE AND A LASER DISTANCE METER UNIT.
3. DIMENSIONS NOMINATED, ARE AT THE DISCRETION OF THE MEASURER. HOWEVER, ALL ATTEMPTS HAVE BEEN MADE IN THE ACCURACY USING BEST PRACTICES AND DUE DILIGENCE.
4. LEVELS AND DIMENSIONS SHOWN ARE SUBJECT TO VERIFICATION BY THIRD PARTY, NAMELY OWNER.
5. CHECK WITH LEVELS AND DIMENSIONS PRIOR TO SCALING FROM DRAWING.
6. LOCATION OF EXISTING SERVICES ARE YET TO BE DETERMINED. FURTHER DETAILED INVESTIGATION REQUIRED.

**LEGEND:**

- REF. REFERENCE
- TYP. TYPICAL
- NOM. NOMINAL
- MAX. MAXIMUM
- CALC. CALCULATED
- (C.O.S.) CHECK ON-SITE
- O/ALL OVERALL
- RCA REVERSE CYCLE AIRCON.
- GL GROUND LEVEL
- FL FLOOR LEVEL
- CL CEILING LEVEL
- CONC. CONCRETE
- FP FLAG POLE
- G GATE

**Rosalie Pech Eva Architect**

ABWA #2150  
 The Old Railway Station  
 104A Robinson Road,  
 Brookton WA 630  
 M 0429 421 287

ISSUE	DATE	REVISION	INT.
1	07.09.16	ISSUED FOR CLIENT CONSIDERATION/ APPROVAL	RJD

SHIRE OF KONDININ

LOT 263 (No.49) GORDON STREET  
 KONDININ

PROPOSED RECREATION CENTRE AS-BUILT

SITE PLAN  
 (EXISTING)

CHKD:	DATE:	APPVD:	DATE:

AS-IS CONSTRUCTED

0427 464 648


COPYRIGHT AS-IS 2016 ALL RIGHTS RESERVED.

JOB No.	DRG No.	REVISION
2016-07-03	AB1 of AB4	1

CAD NAME: PLOT DATE:



**SITE PLAN**  
 1: 200

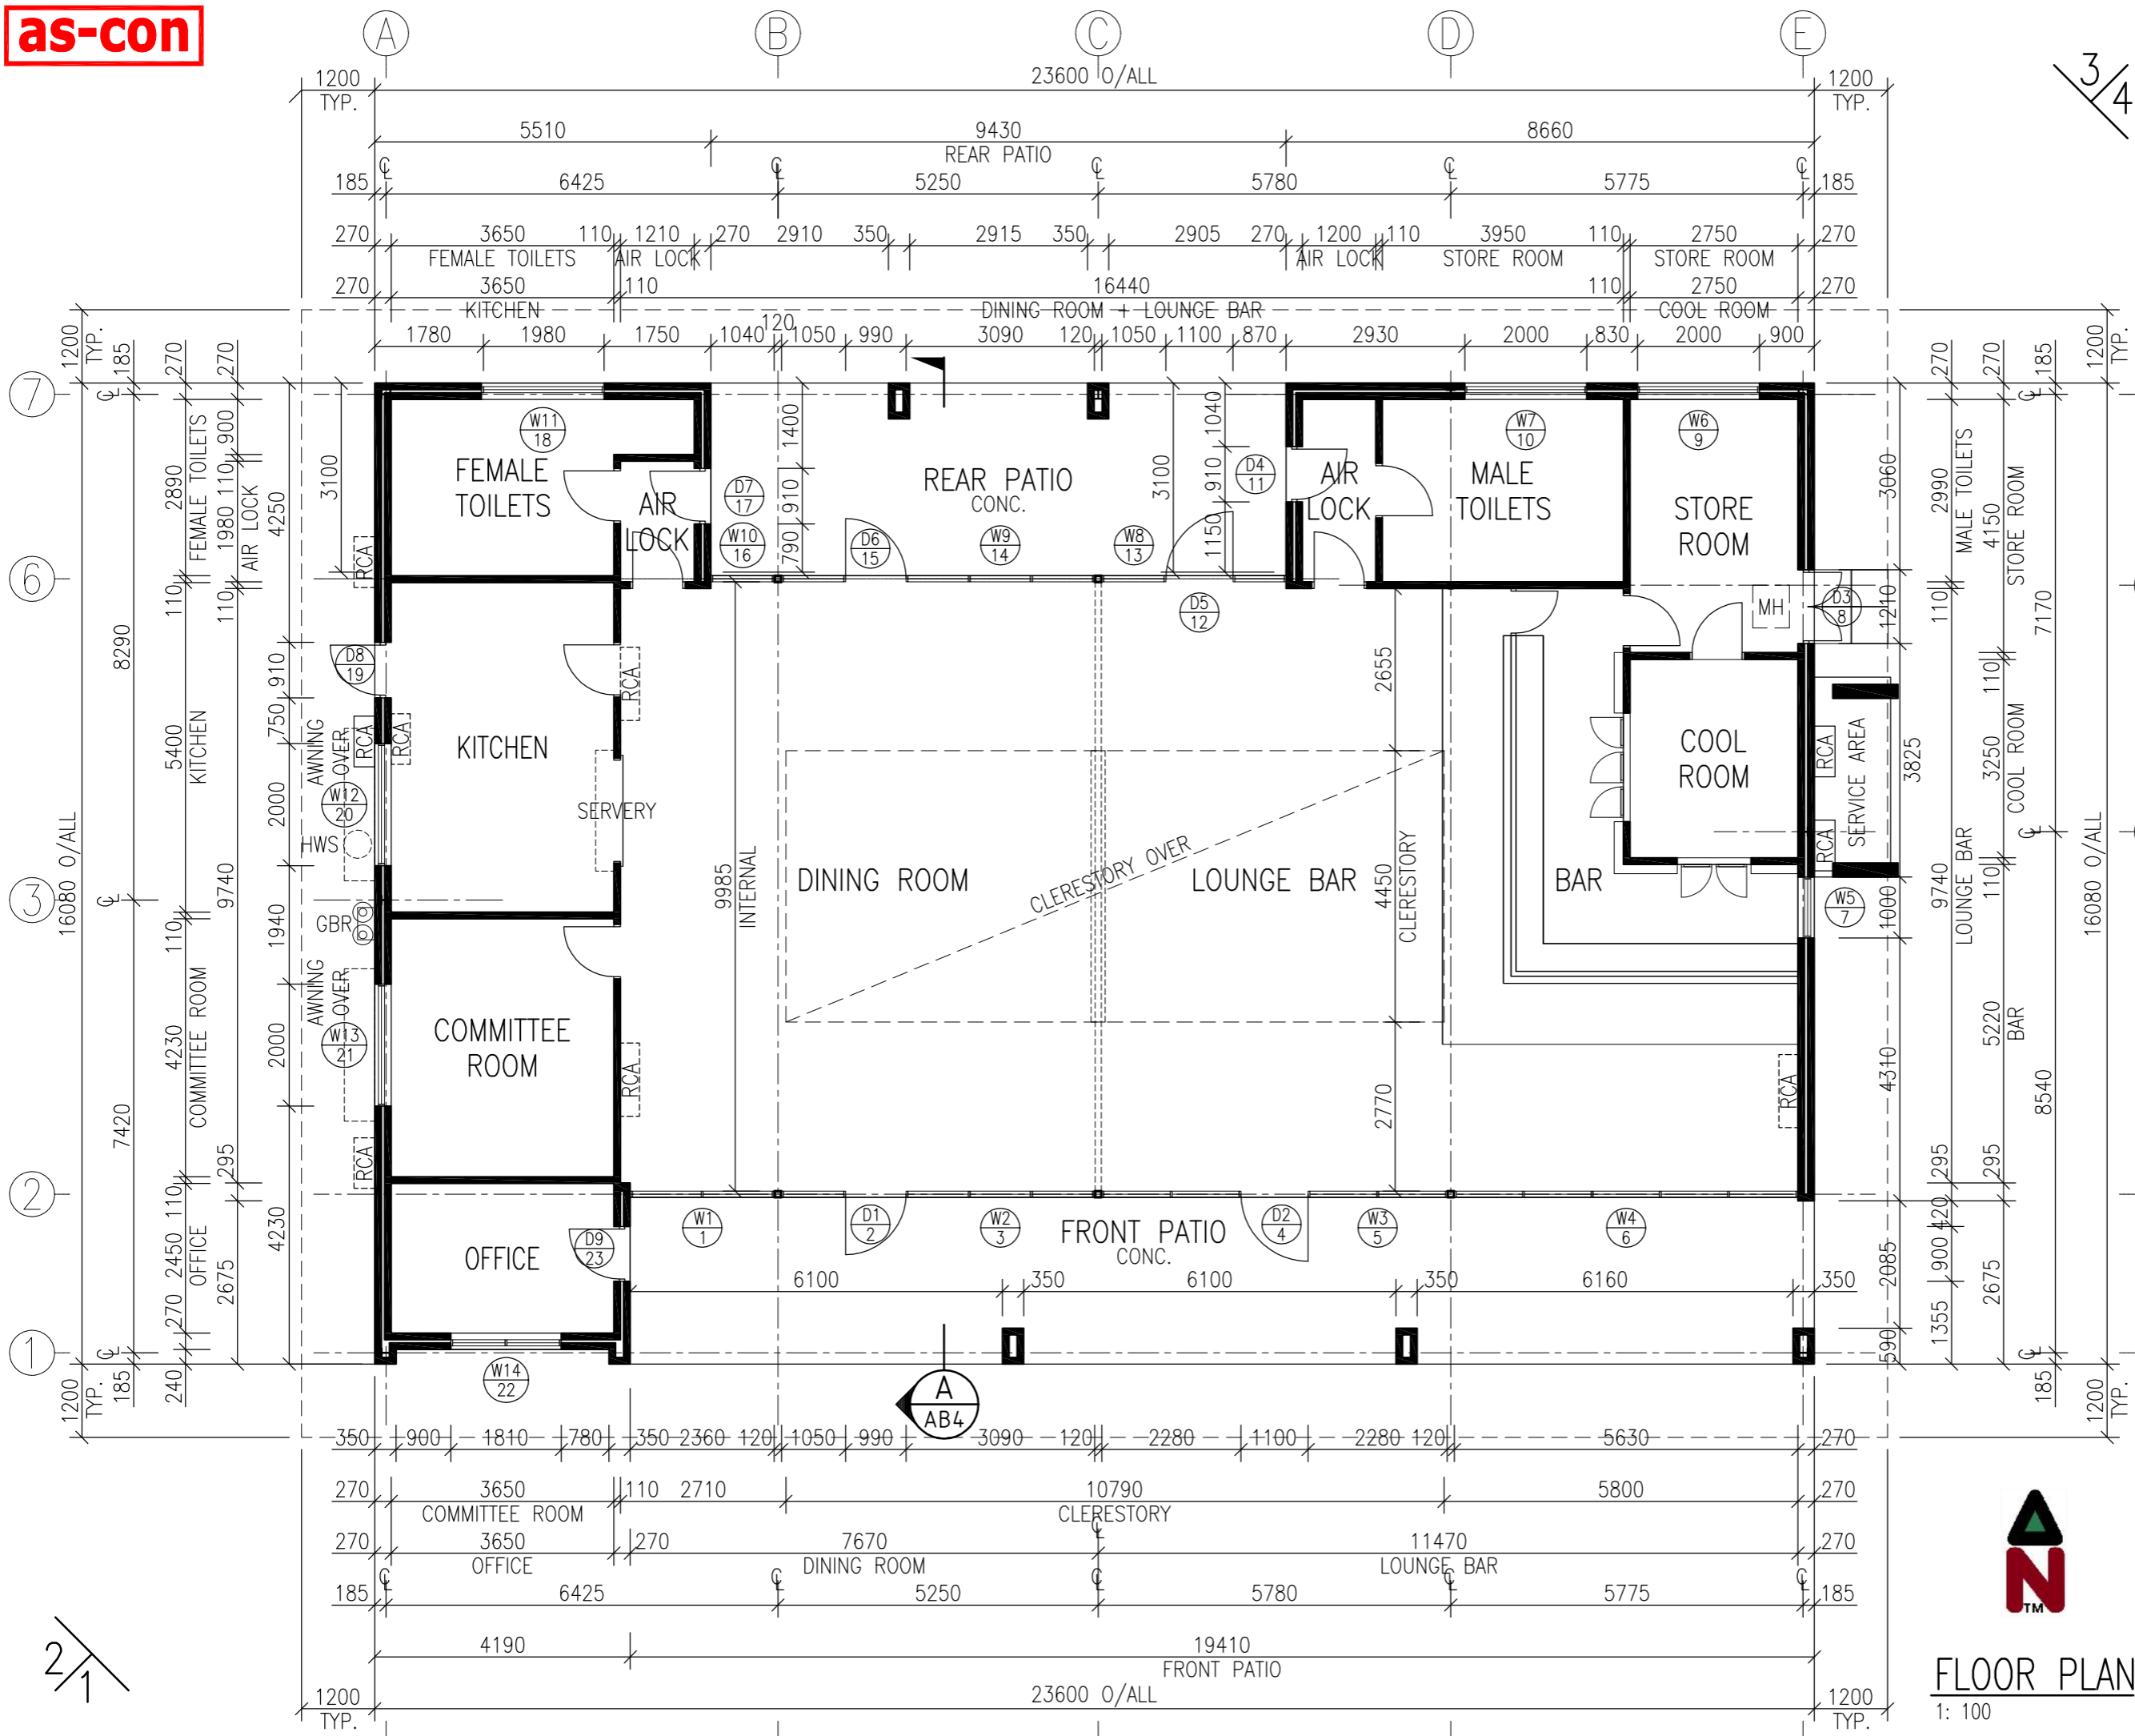

3/4

- NOTE:**
1. DRAWING REPRESENTS BUILDING(S) IN EXISTING STATE AS COMPOSED FROM ONSITE MEASUREMENTS AND DETAILED OBSERVATIONS (PHOTOS).
  2. STATED DIMENSIONS, ARE DERIVED FROM THE USE OF A MEASURING TAPE DEVICE AND A LASER DISTANCE METER UNIT.
  3. DIMENSIONS NOMINATED, ARE AT THE DISCRETION OF THE MEASURER. HOWEVER, ALL ATTEMPTS HAVE BEEN MADE IN THE ACCURACY USING BEST PRACTICES AND DUE DILIGENCE.
  4. LEVELS AND DIMENSIONS SHOWN ARE SUBJECT TO VERIFICATION BY THIRD PARTY, NAMELY OWNER.
  5. CHECK WITH LEVELS AND DIMENSIONS PRIOR TO SCALING FROM DRAWING.
  6. LOCATION OF EXISTING SERVICES ARE YET TO BE DETERMINED. FURTHER DETAILED INVESTIGATION REQUIRED.

- LEGEND:**
- REF. REFERENCE
  - TYP. TYPICAL
  - NOM. NOMINAL
  - MAX. MAXIMUM
  - CALC. CALCULATED
  - (C.O.S.) CHECK ON-SITE
  - O/ALL OVERALL
  - RCA REVERSE CYCLE AIRCON.
  - GL GROUND LEVEL
  - FL FLOOR LEVEL
  - CL CEILING LEVEL
  - CONC. CONCRETE
  - MH MANHOLE
  - RCA REVERSE CYCLE AIRCON.
  - HWS HOT WATER SYSTEM
  - GBR GAS BOTTLES/REGULATOR

**Rosalie Pech Eva Architect**


ABWA #2150  
 The Old Railway Station  
 104A Robinson Road,  
 Brookton WA 630  
 M 0429 421 287

1	07.09.16	ISSUED FOR CLIENT CONSIDERATION/ APPROVAL	RWD
ISSUE	DATE	REVISION	INT.
SHIRE OF KONDININ			
LOT 263 (No.49) GORDON STREET KONDININ			
PROPOSED RECREATION CENTRE AS-BUILT			
FLOOR PLAN (EXISTING)			
CHKD:	DATE:	APPVD:	DATE:
<b>AS-IS</b>		DRAWN R/JVD	
<b>CONSTRUCTED</b>		DATE 29.08.16	
0427 464 648		DATUM	
COPYRIGHT AS-IS 2016 ALL RIGHTS RESERVED.			
JOB No. 2016-07-03	DRG No. AB2 of AB4	SCALE AS SHOWN	REVISION 1
CAD NAME:	PLOT DATE:		




**FLOOR PLAN**  
1: 100


2/1

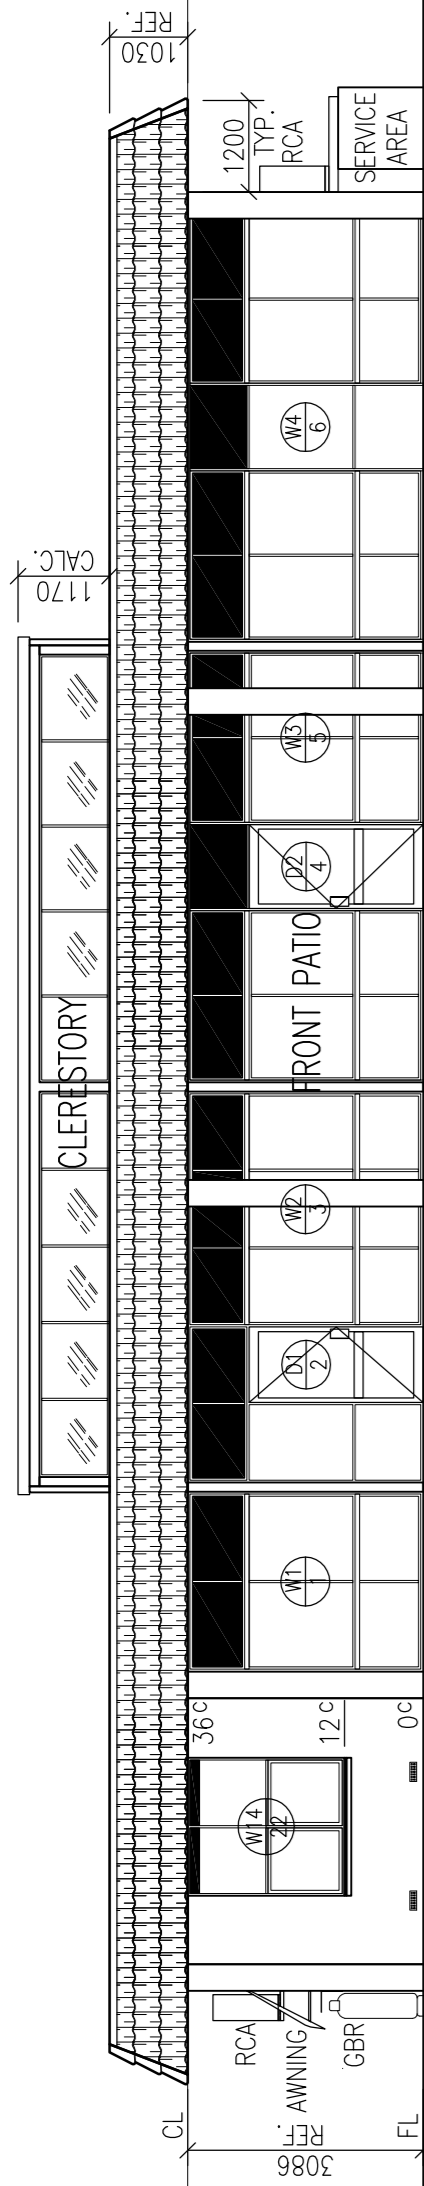


**ELEVATION 1**  
1: 100 (SOUTH)

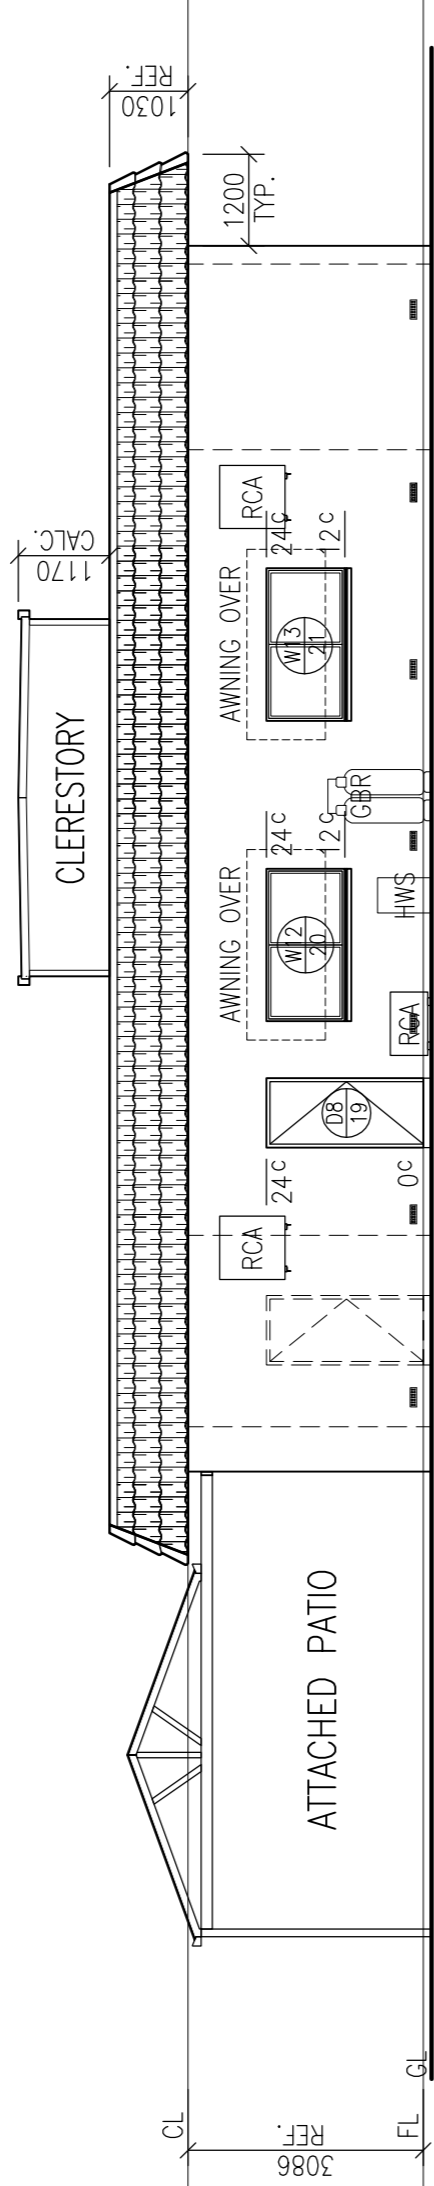

**ELEVATION 2**  
1: 100 (WEST)

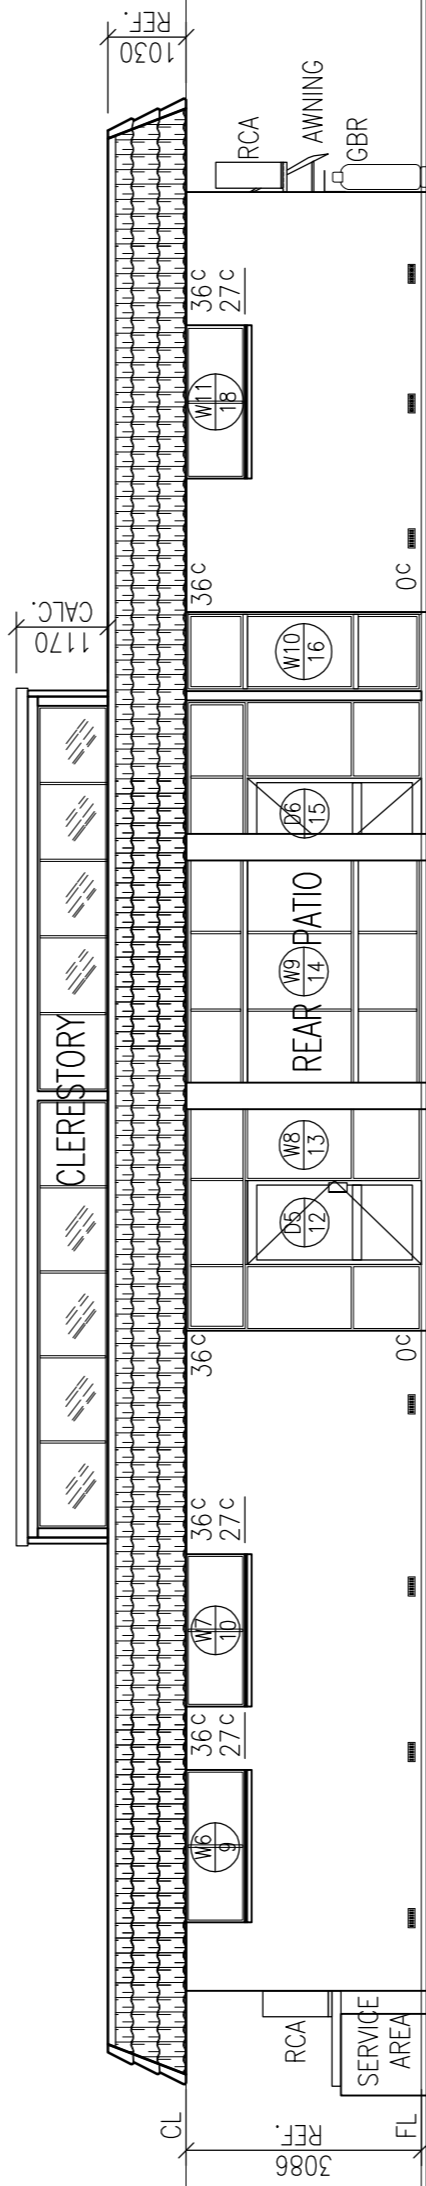

**ELEVATION 3**  
1: 100 (NORTH)

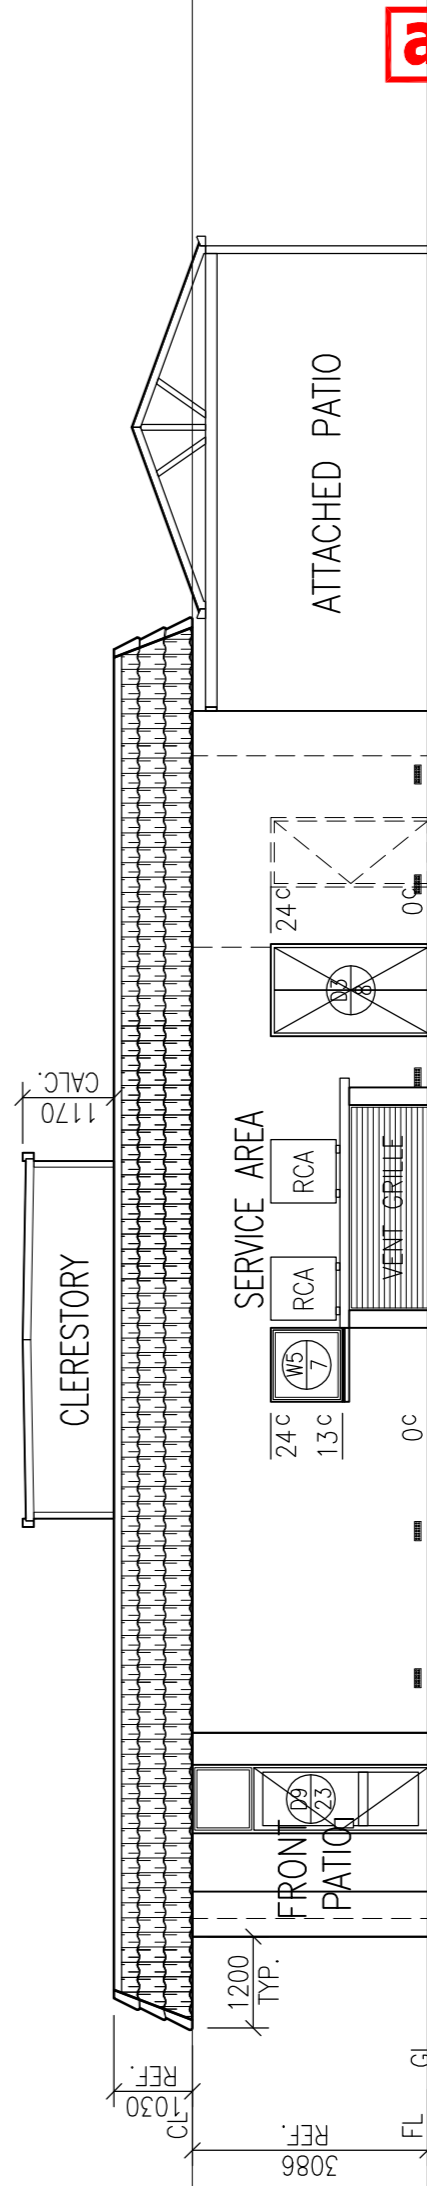

**ELEVATION 4**  
1: 100 (EAST)



- NOTE:**
- DRAWING REPRESENTS BUILDING(S) IN EXISTING STATE AS COMPOSED FROM ONSITE MEASUREMENTS AND DETAILED OBSERVATIONS (PHOTOS).
  - STATED DIMENSIONS, ARE DERIVED FROM THE USE OF A MEASURING TAPE DEVICE AND A LASER DISTANCE METER UNIT.
  - DIMENSIONS NOMINATED, ARE AT THE DISCRETION OF THE MEASURER. HOWEVER, ALL ATTEMPTS HAVE BEEN MADE IN THE ACCURACY USING BEST PRACTICES AND DUE DILIGENCE.
  - LEVELS AND DIMENSIONS SHOWN ARE SUBJECT TO VERIFICATION BY THIRD PARTY, NAMELY OWNER.
  - CHECK WITH LEVELS AND DIMENSIONS PRIOR TO SCALING FROM DRAWING.
  - LOCATION OF EXISTING SERVICES ARE YET TO BE DETERMINED. FURTHER DETAILED INVESTIGATION REQUIRED.

- LEGEND:**
- REF. REFERENCE
  - TYP. TYPICAL
  - NOM. NOMINAL
  - MAX. MAXIMUM
  - CALC. CALCULATED
  - (C.O.S.) CHECK ON-SITE
  - O/ALL OVERALL
  - RCA REVERSE CYCLE AIRCON.
  - GL GROUND LEVEL
  - FL FLOOR LEVEL
  - CL CEILING LEVEL
  - CONC. CONCRETE
  - RCA REVERSE CYCLE AIRCON.
  - HWS HOT WATER SYSTEM
  - GBR GAS BOTTLES/REGULATOR

**Rosalie Pech Eva Architect**

ABWA #2150  
The Old Railway Station  
104A Robinson Road,  
Brookton WA 630  
M 0429 421 287

ISSUE	DATE	ISSUED FOR CLIENT CONSIDERATION/ APPROVAL	REVISION	R/W/D	INT.
1	07.09.16	ISSUED FOR CLIENT CONSIDERATION/ APPROVAL			

SHIRE OF KONDININ

LOT 263 (No.49) GORDON STREET  
KONDININ

PROPOSED RECREATION CENTRE AS-BUILT

ELEVATIONS  
(EXISTING)


CHKD:	DATE:	APPVD:	DATE:

AS-IS	CONSTRUCTED
0427 464 648	

COPYRIGHT AS-IS 2016 ALL RIGHTS RESERVED.

JOB No.	DRG No.	REVISION
2016-07-03	AB3 of AB4	1

CAD NAME:	PLOT DATE:

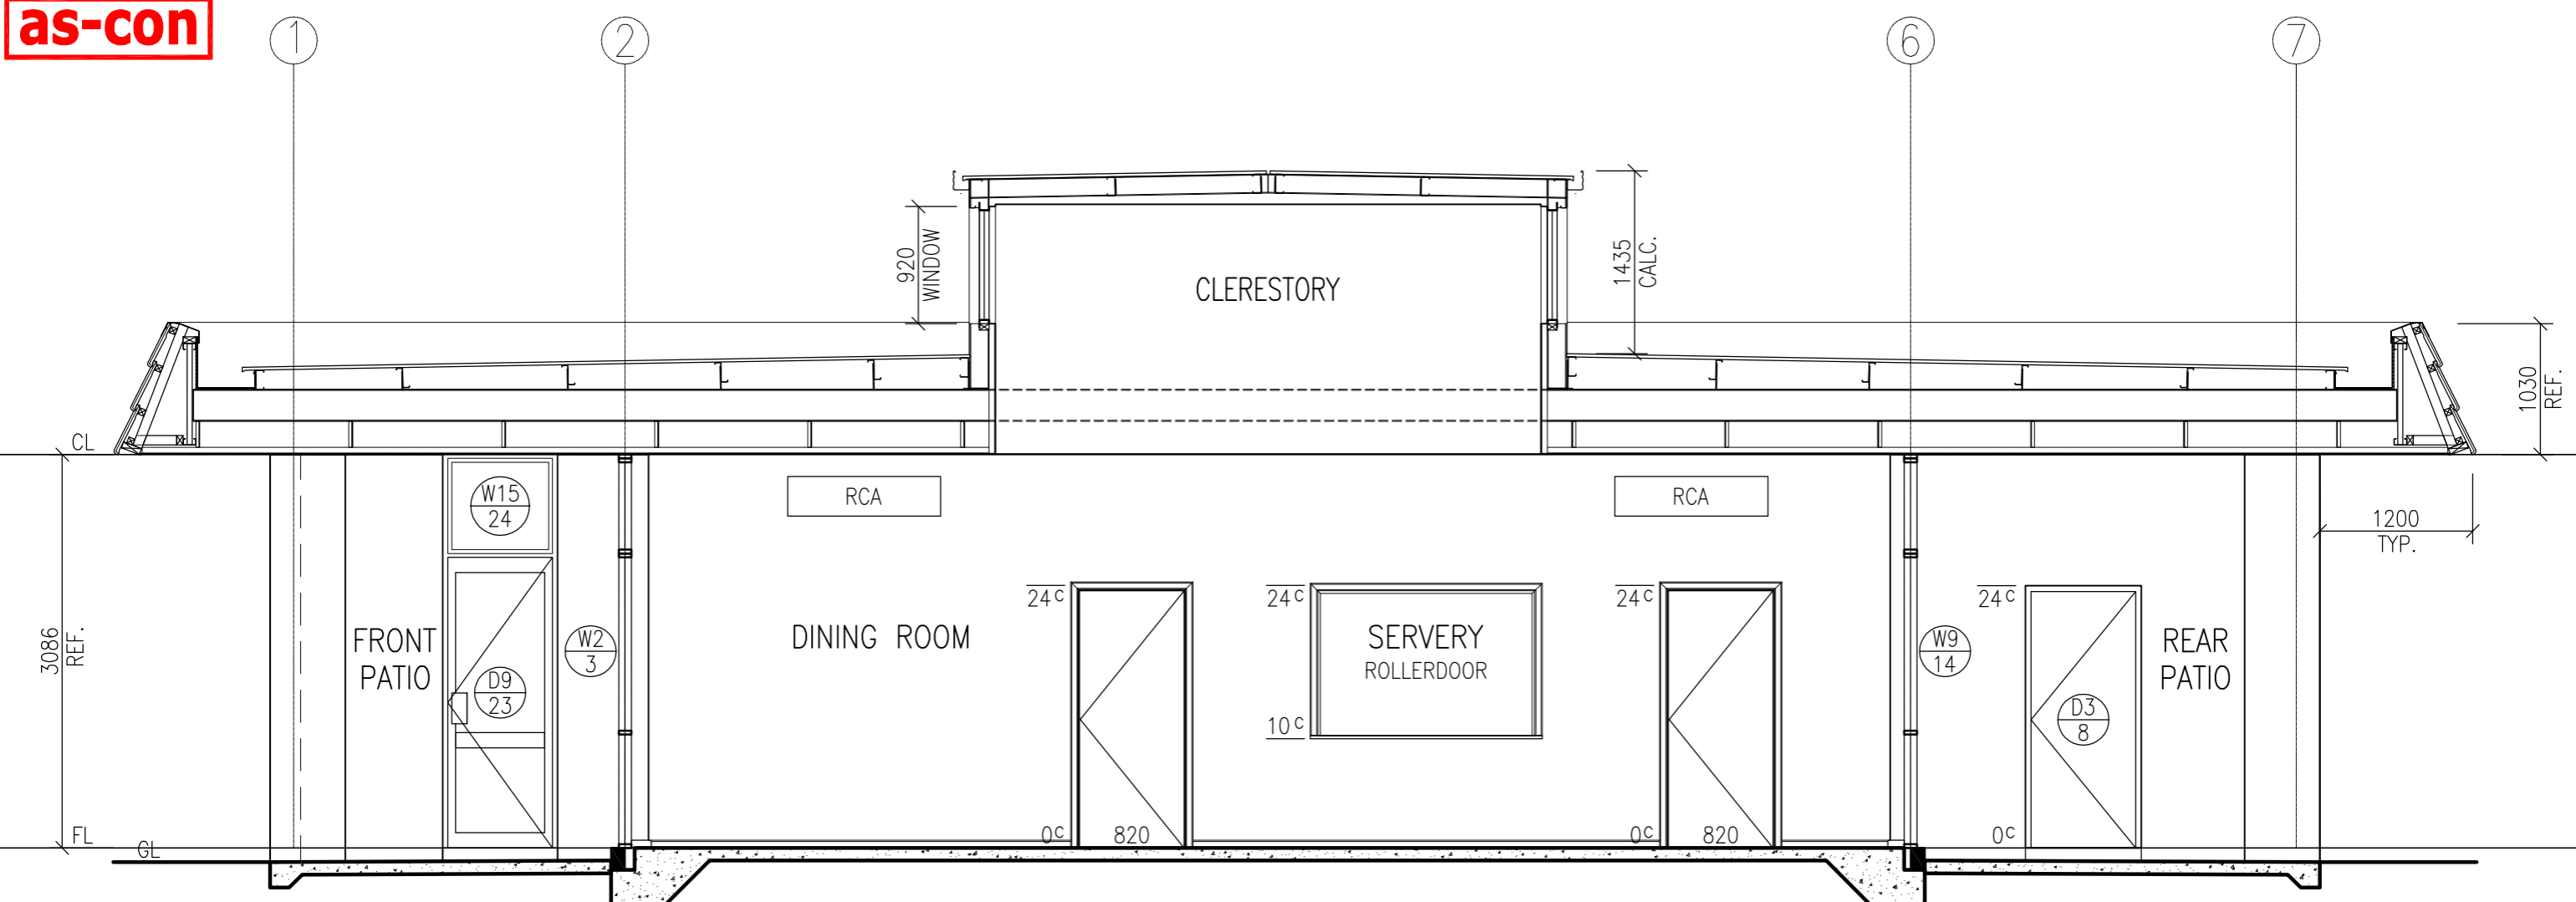

**NOTE:**

1. DRAWING REPRESENTS BUILDING(S) IN EXISTING STATE AS COMPOSED FROM ONSITE MEASUREMENTS AND DETAILED OBSERVATIONS (PHOTOS).
2. STATED DIMENSIONS, ARE DERIVED FROM THE USE OF A MEASURING TAPE DEVICE AND A LASER DISTANCE METER UNIT.
3. DIMENSIONS NOMINATED, ARE AT THE DISCRETION OF THE MEASURER. HOWEVER, ALL ATTEMPTS HAVE BEEN MADE IN THE ACCURACY USING BEST PRACTICES AND DUE DILIGENCE.
4. LEVELS AND DIMENSIONS SHOWN ARE SUBJECT TO VERIFICATION BY THIRD PARTY, NAMELY OWNER.
5. CHECK WITH LEVELS AND DIMENSIONS PRIOR TO SCALING FROM DRAWING.
6. LOCATION OF EXISTING SERVICES ARE YET TO BE DETERMINED. FURTHER DETAILED INVESTIGATION REQUIRED.

- LEGEND:**
- REF. REFERENCE
  - TYP. TYPICAL
  - NOM. NOMINAL
  - MAX. MAXIMUM
  - CALC. CALCULATED
  - (C.O.S.) CHECK ON-SITE
  - O/ALL OVERALL
  - RCA REVERSE CYCLE AIRCON.
  - GL GROUND LEVEL
  - FL FLOOR LEVEL
  - CL CEILING LEVEL
  - CONC. CONCRETE
  - RCA REVERSE CYCLE AIRCON.

SECTION **A**  
1: 50  
AB2

1		07.09.16	ISSUED FOR CLIENT CONSIDERATION/ APPROVAL	RJV
ISSUE	DATE	REVISION	REVISION	INT.
SHIRE OF KONDININ				
LOT 263 (No.49) GORDON STREET KONDININ				
PROPOSED RECREATION CENTRE AS-BUILT				
SECTION (EXISTING)				
CHKD:	DATE:	APPVD:	DATE:	
<b>AS-IS</b>		DRAWN RJV		
<b>CONSTRUCTED</b>		DATE 29.08.16		
0427 464 648		DATUM		
COPYRIGHT AS-IS 2016 ALL RIGHTS RESERVED.		SCALE AS SHOWN		
JOB No. 2016-07-03	DRG No. AB4 OF AB4	REVISION 1		
CAD NAME:	PLOT DATE:			